

THIS DESIGN IS PROPRIETARY TO
ELLIOTT BAY DESIGN GROUP, LTD.
 SEATTLE, WA, USA. IT SHALL NOT BE USED FOR
 CONSTRUCTION OR SUBMITTED TO OUTSIDE
 PARTIES WITHOUT OUR WRITTEN CONSENT.
 © 2008 ELLIOTT BAY DESIGN GROUP.

REVISION HISTORY


REV	ZONE	DESCRIPTION	DWN	DATE	APVD
A	2-ALL	ADDED AND CHANGED ALL TANK NAMES	CCE	3/30/06	RJV
A	2-A5	ADDED AFT CRANE FOUNDATION	CCE	3/30/06	RJV
B	2-ALL 3-ALL	MODIFIED TONNAGE OPENINGS	RJV	5/15/06	RJV
C	ALL	INCORPORATED SHIPCHECK NOTES AND ISSUED AS-BUILT	RJV	1/19/07	RJV

GENERAL NOTES


- ALL DESIGN, FABRICATION AND WELDING PROCESSES SHALL BE IN ACCORDANCE WITH THE LATEST ABS RULES FOR BUILDING AND CLASSING STEEL VESSELS AND USCG REQUIREMENTS PER 46 CFR.
- ALL PLATE AND SHAPE MATERIAL SHALL BE STEEL, ABS GRADE A OR EQUIVALENT. ALL PIPE SHALL BE SEAMLESS, STEEL, ASTM A53, OR EQUAL.
- NEW SUPPORT STRUCTURE SHALL BE FIELD FITTED TO ALIGN WITH EXISTING SHIP STRUCTURE.
- VERIFY DIMENSIONS PRIOR TO FABRICATION AND INSTALLATION.
- STANDARD STRUCTURAL DETAILS TO BE DEFINED BY SHIPYARD.
- OUTFIT AND MISC. DETAILS TO BE DETERMINED & CONFIRMED BY SHIPYARD AND OWNER.
- AS-BUILT UPDATES INCORPORATED PER SHIP CHECK CONDUCTED 8-10 JAN 2007. THIS DRAWING REPRESENTS DETAILS VISIBLE AT THE TIME OF SURVEY WITHOUT DISASSEMBLY OF VESSEL STRUCTURE, JOINERY, LININGS, ETC.

REFERENCES

- 051000-6-2143 01 WINCH DECK RIPOUT & REPAIR SCANTLINGS
- 051000-6-2141 CTD GARAGE CONVERSION, RIPOUT & REPAIR SCANTLINGS
- 051000-6-2142 02 DECK HOUSE REARRANGEMENTS, RIPOUT & REPAIR SCANTLINGS
- 05100-6-2148 NAVIGATION MAST MODIFICATIONS
- 05100-6-2145 CENTRAL STAIRWAY CONSTRUCTION RIPOUT & REPAIR SCANTLINGS
- 05100-6-2144 01 DECKHOUSE REARRANGEMENTS RIPOUT & REPAIR SCANTLINGS
- 05100-6-2147 NEW 03 WHEELHOUSE CONSTRUCTION & SCANTLINGS
- 05100-6-2040 RIPOUT & REPAIR KEY PLAN

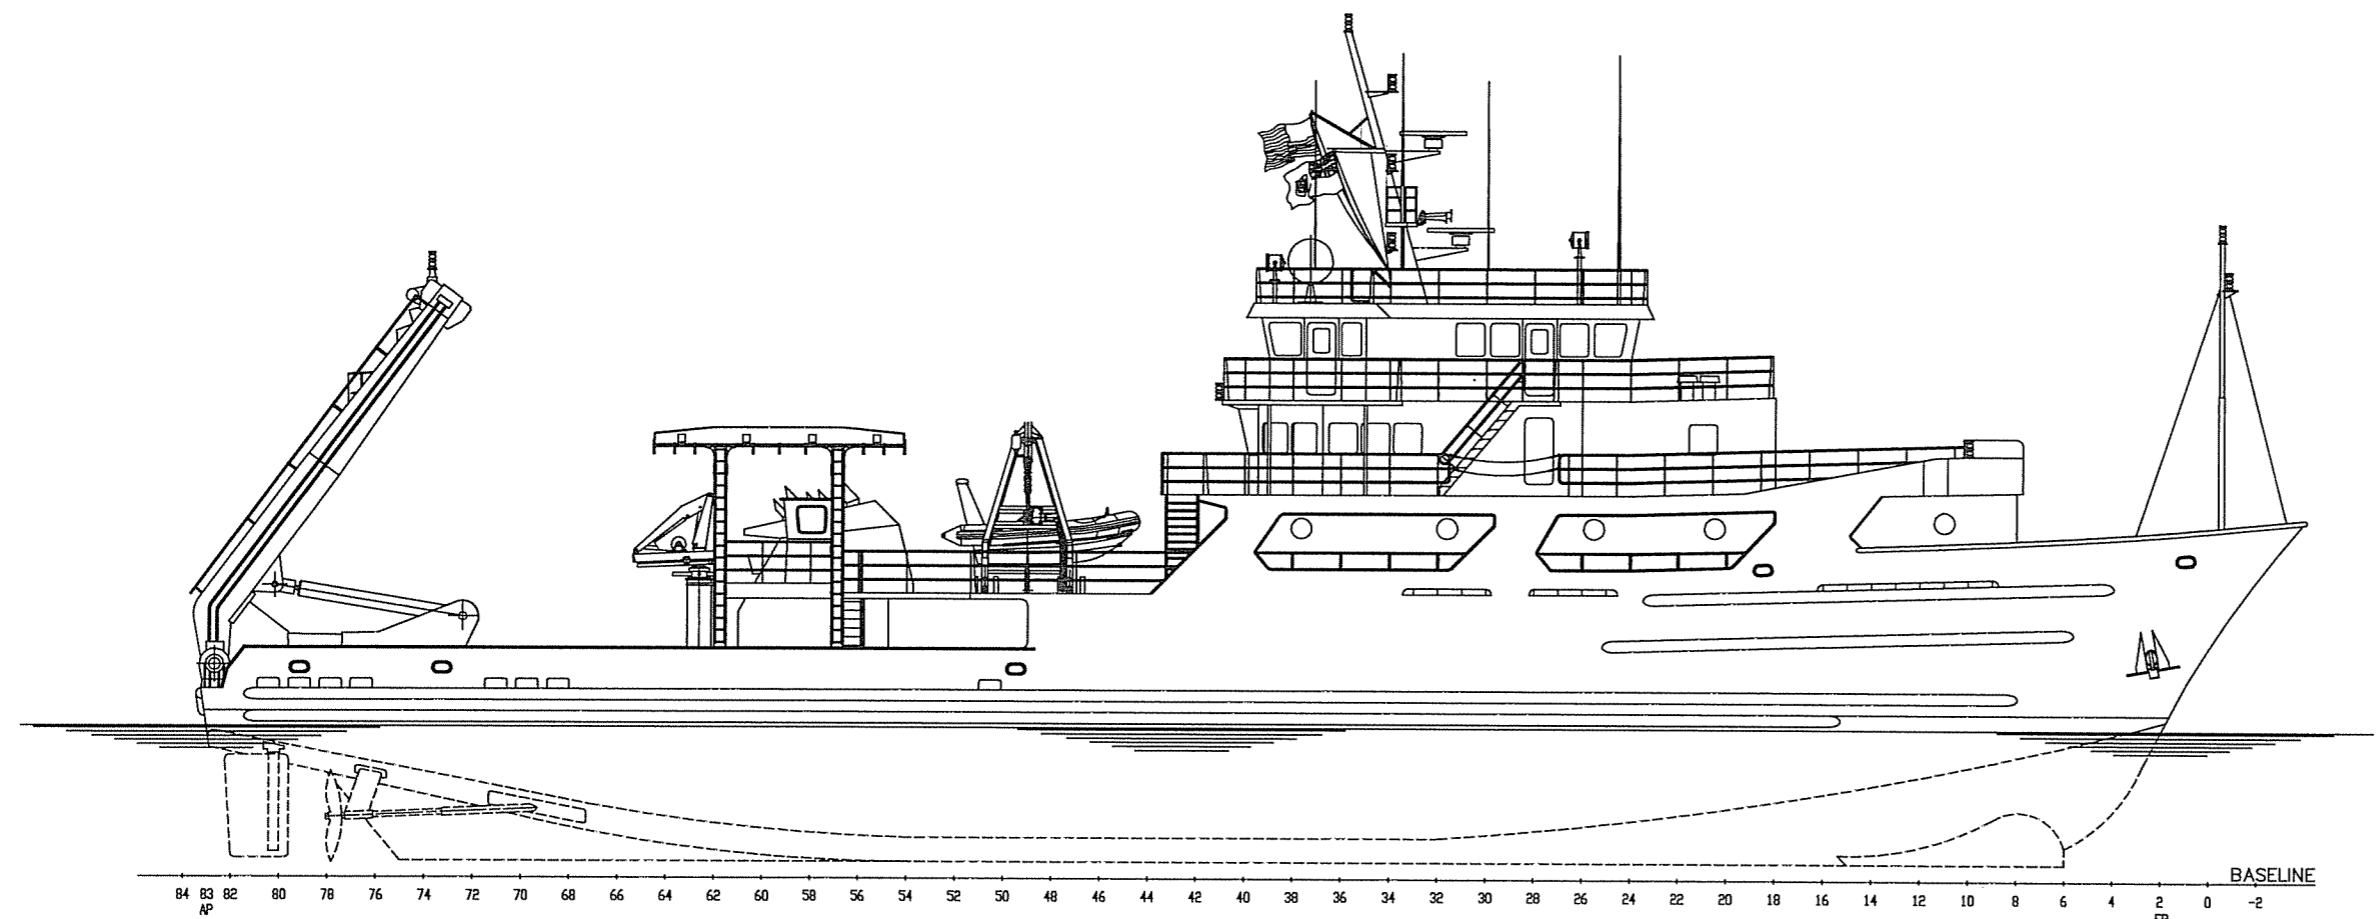

ELEV 1-4B
 OUTBOARD PROFILE
 SCALE: 1/8"=1'-0"

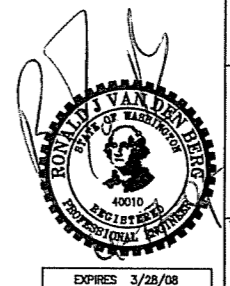

Elliott Bay Design Group
 Seattle - New Orleans

CLIENT: Bermuda Biological Station For Research


PROJECT: R/V ATLANTIC EXPLORER MODIFICATIONS

HALF SIZE PRINT


AS-BUILT

GENERAL ARRANGEMENT

DWN	JPH	DATE	02/24/06	SIZE	D	DWG NO.	05100-6-1041	REV	C
APVD		DATE		SCALE	AS NOTED	FILE NAME	1041C_05100_6	SHEET	1 OF 4

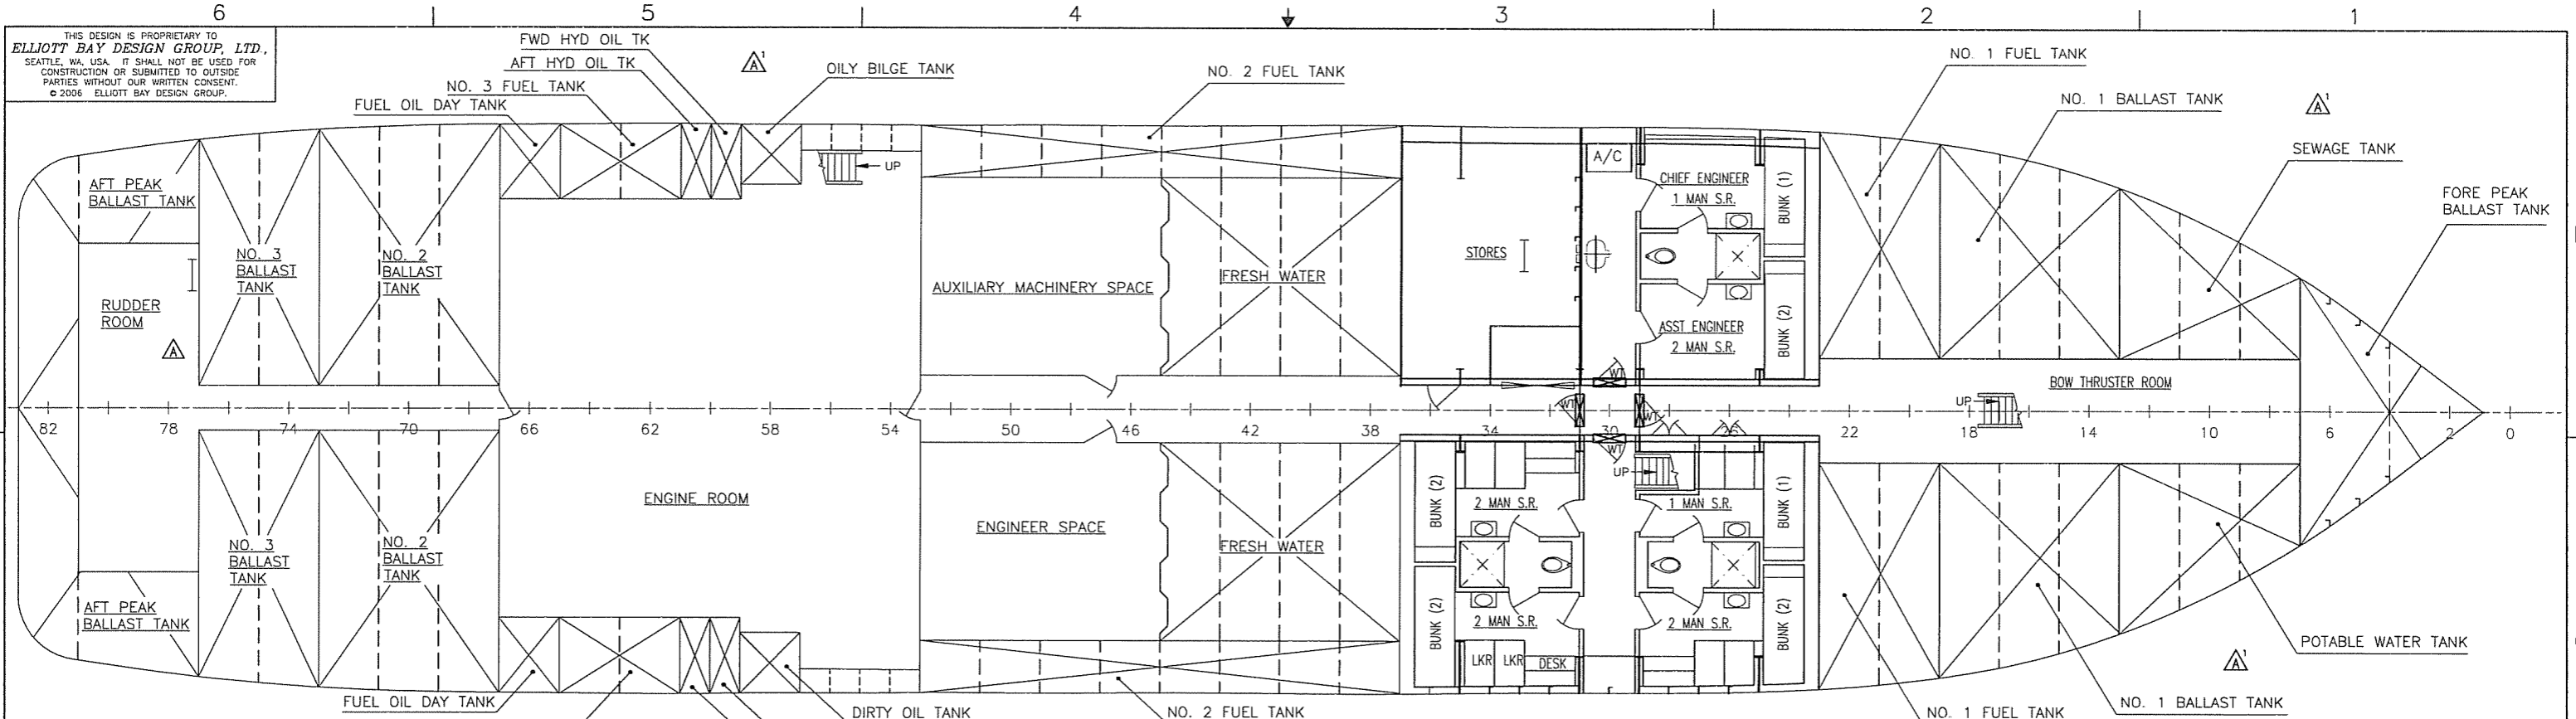


PLAN 2-3C
HOLD PLAN
SCALE: 3/16"=1'-0"

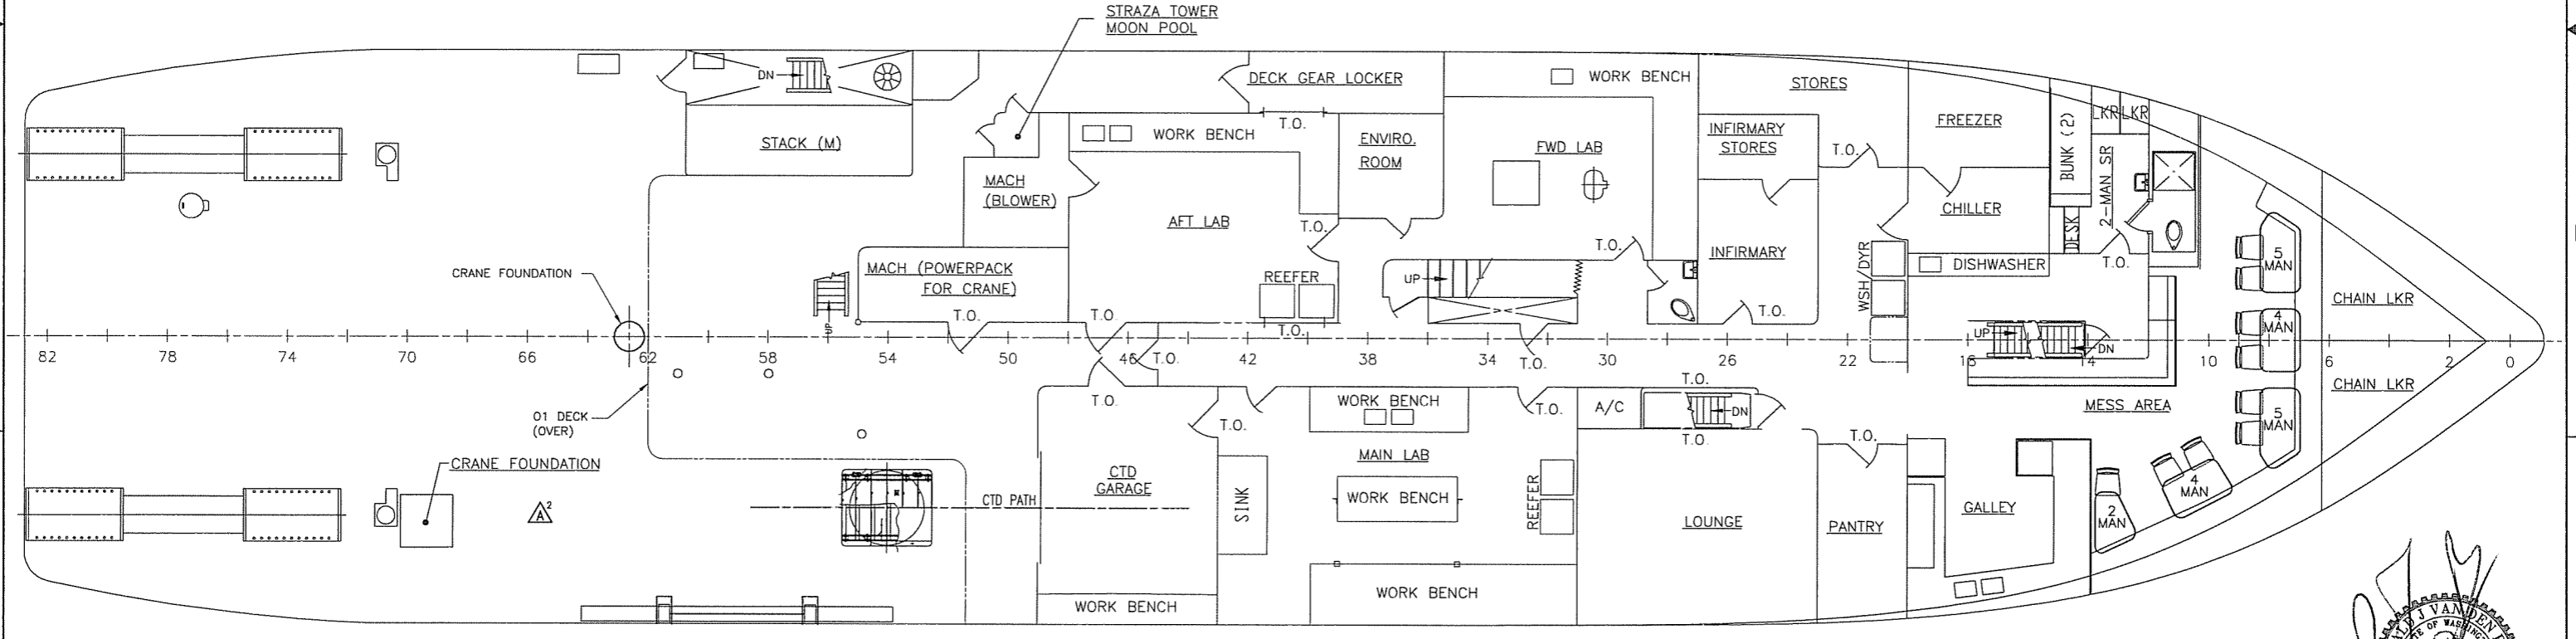

PLAN 2-3A
MAIN DECK
SCALE: 3/16"=1'-0"


HALF SIZE PRINT
AS-BUILT

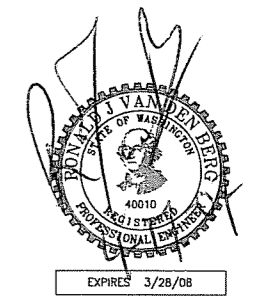


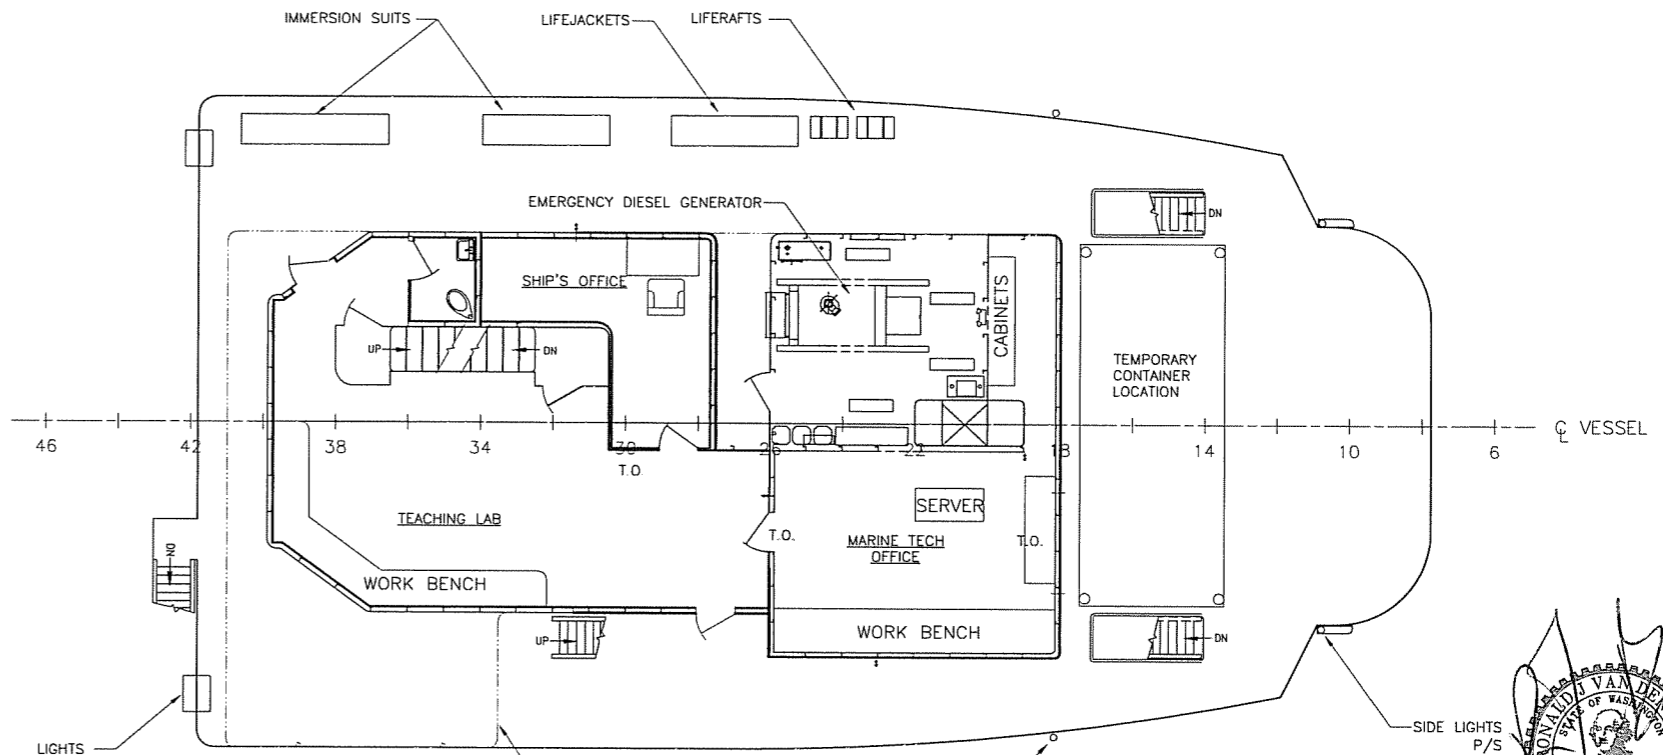
SIZE	D	ENG. NO.	05100-6-1041	REV	C
SCALE	AS NOTED	FILE NAME	1041C_5100_6	SHEET	2 OF 4


4/17/2007 12:03:06 PM

THIS DESIGN IS PROPRIETARY TO
ELLIOTT BAY DESIGN GROUP, LTD.
 SEATTLE, WA, USA. IT SHALL NOT BE USED FOR
 CONSTRUCTION OR SUBMITTED TO OUTSIDE
 PARTIES WITHOUT OUR WRITTEN CONSENT.
 © 2006 ELLIOTT BAY DESIGN GROUP.

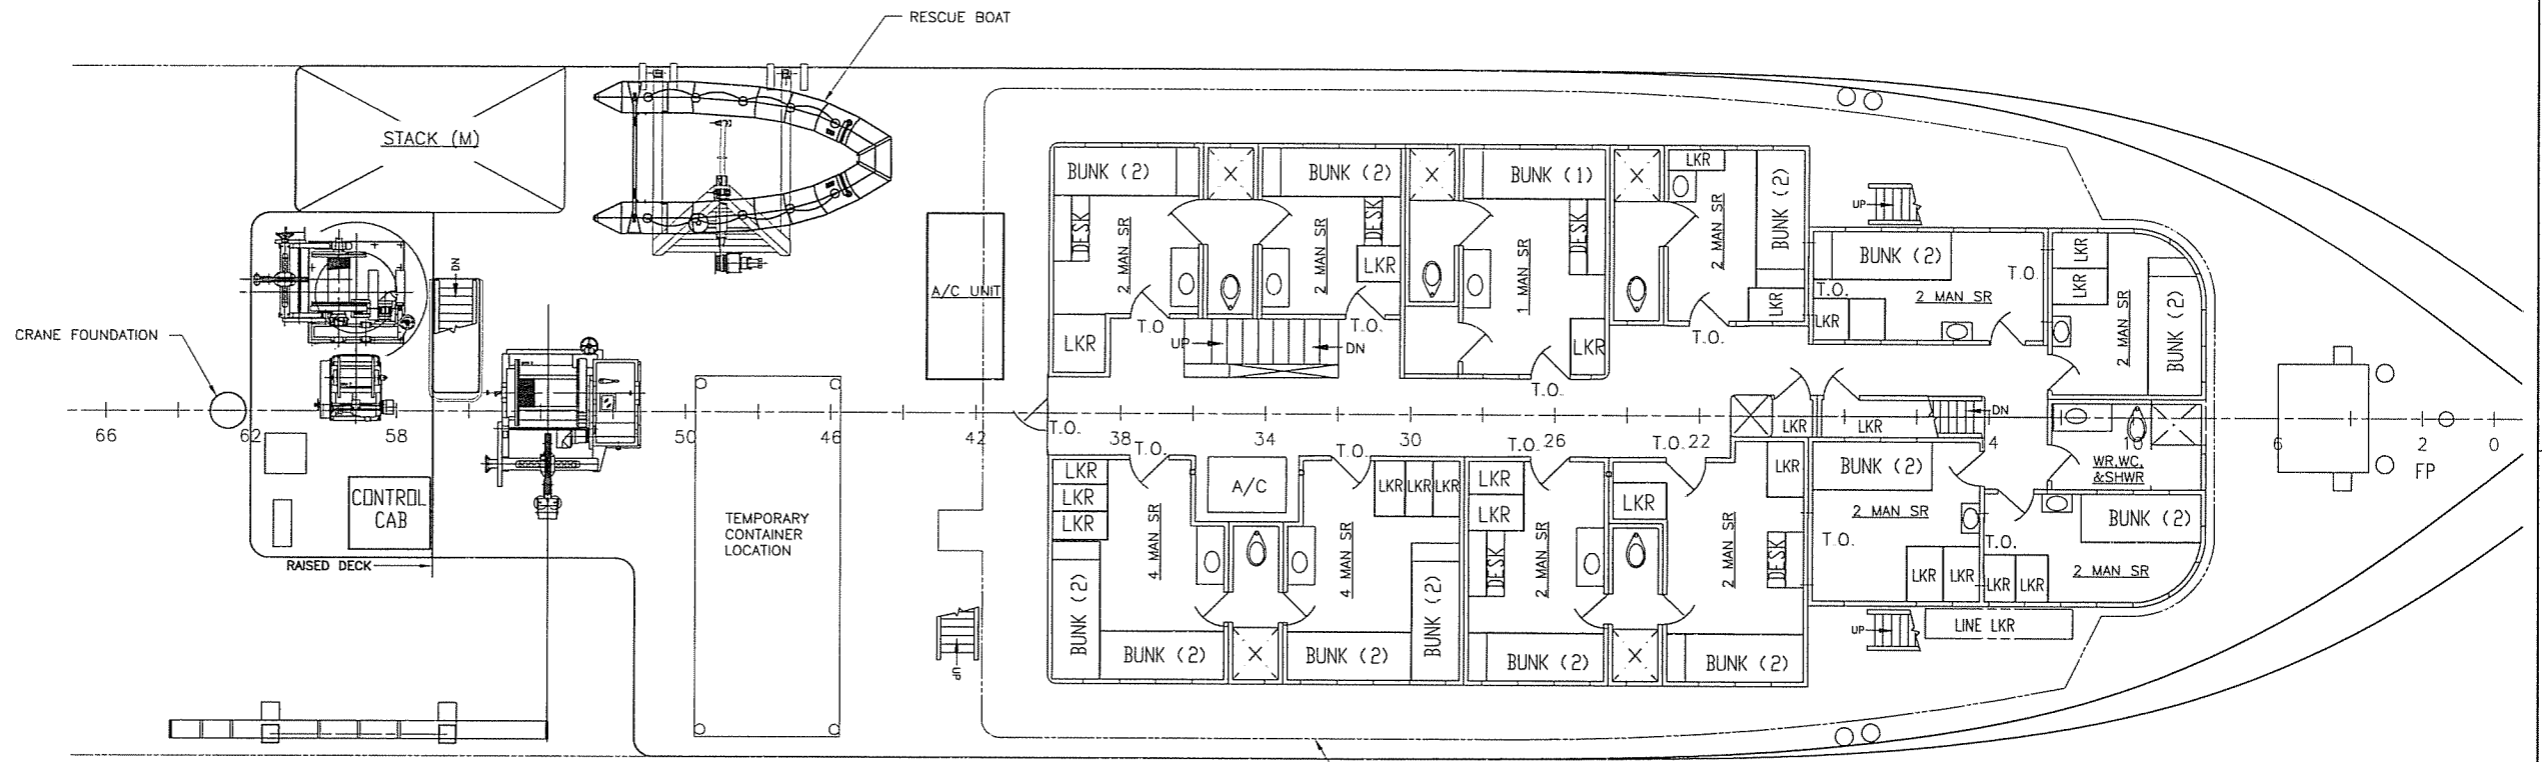

 PLAN 3-3C 
 01 DECK
 SCALE: 3/16"=1'-0"



PLAN 3-3A 
 02 DECK
 SCALE: 3/16"=1'-0"


**HALF SIZE PRINT
 AS-BUILT**




SIZE	DWG NO.	REV
D	05100-6-1041	C
SCALE	FILE NAME	SHEET
AS NOTED	1041C_5100_6	3 OF 4

4/17/2007 12:03:21 PM

THIS DESIGN IS PROPRIETARY TO
ELLIOTT BAY DESIGN GROUP, LTD.
 SEATTLE, WA, USA. IT SHALL NOT BE USED FOR
 CONSTRUCTION OR SUBMITTED TO OUTSIDE
 PARTIES WITHOUT OUR WRITTEN CONSENT.
 © 2006 ELLIOTT BAY DESIGN GROUP.

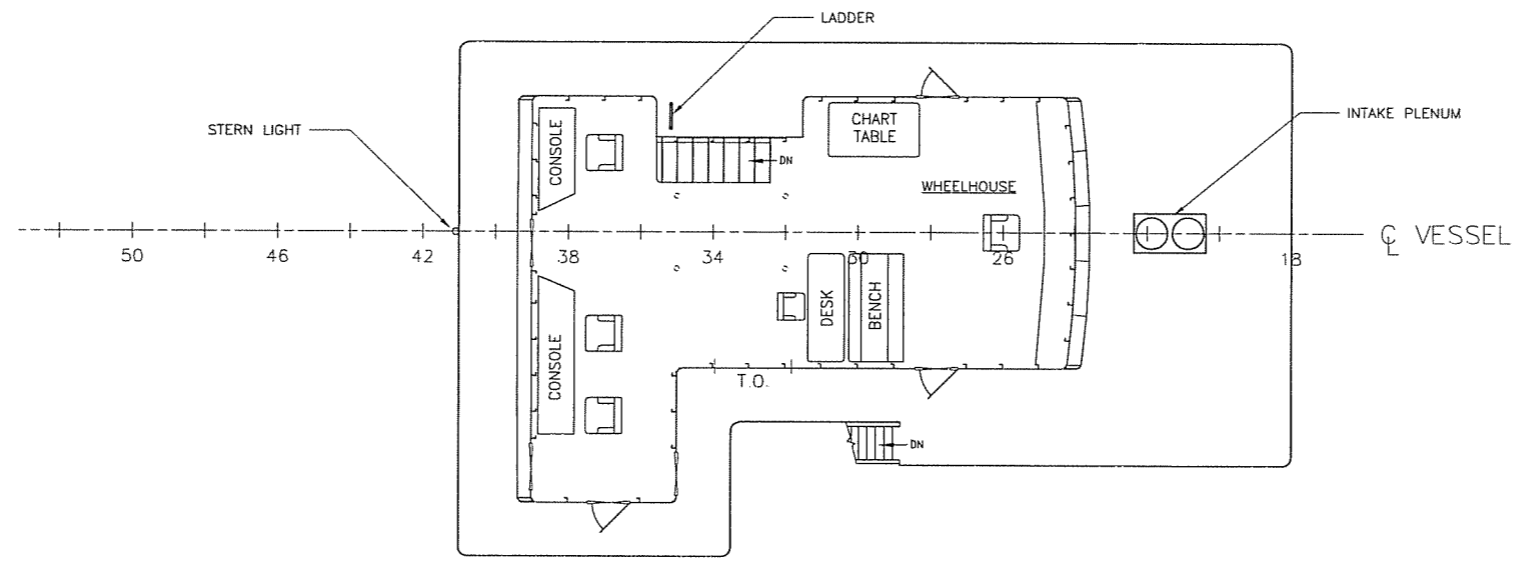


PLAN 4-3C
 03 DECK
 SCALE: 3/16"=1'-0"

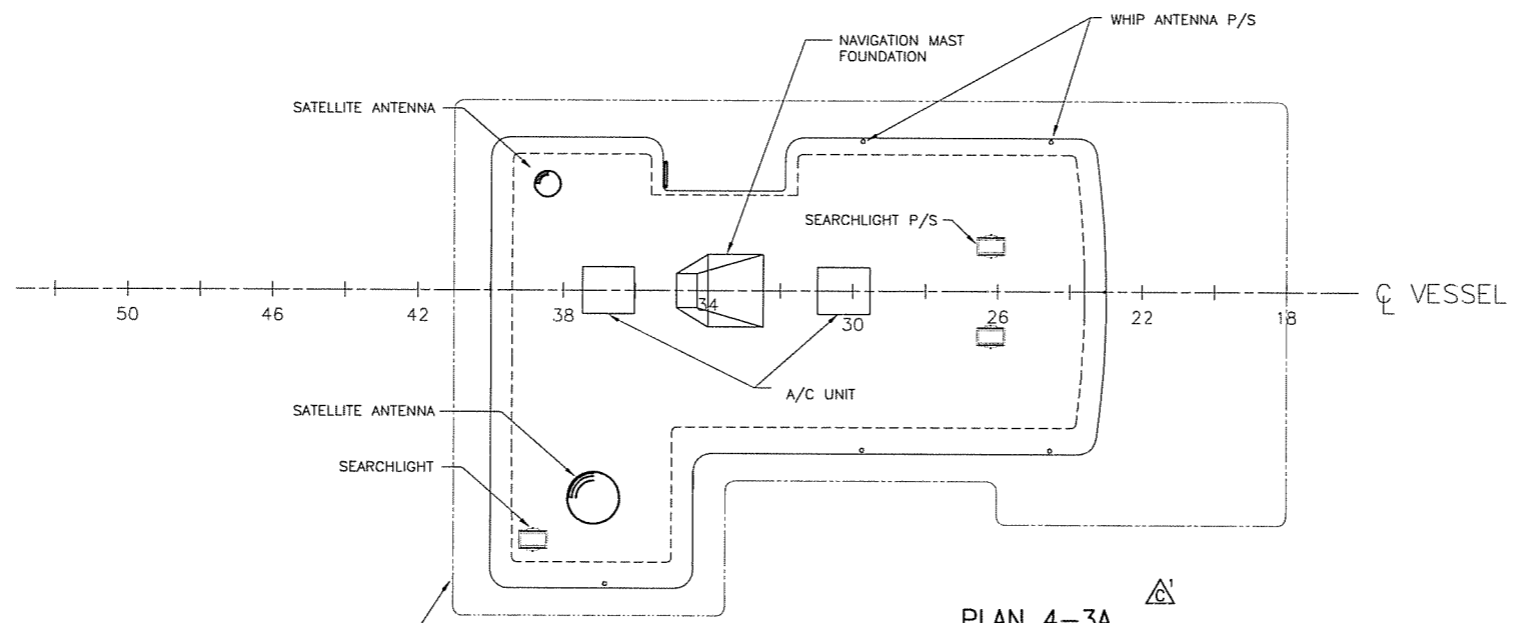

PLAN 4-3A
 WHEELHOUSE TOP
 SCALE: 3/16"=1'-0"

**HALF SIZE PRINT
 AS-BUILT**

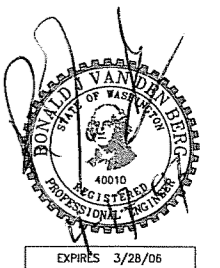

SIZE	DWG NO.	REV
D	05100-6-1041	C
SCALE	FILE NAME	SHEET
AS NOTED	1041C_5100_6	4 OF 4

4/17/2007 12:05:35 PM